


LOCATION 1:500@A3

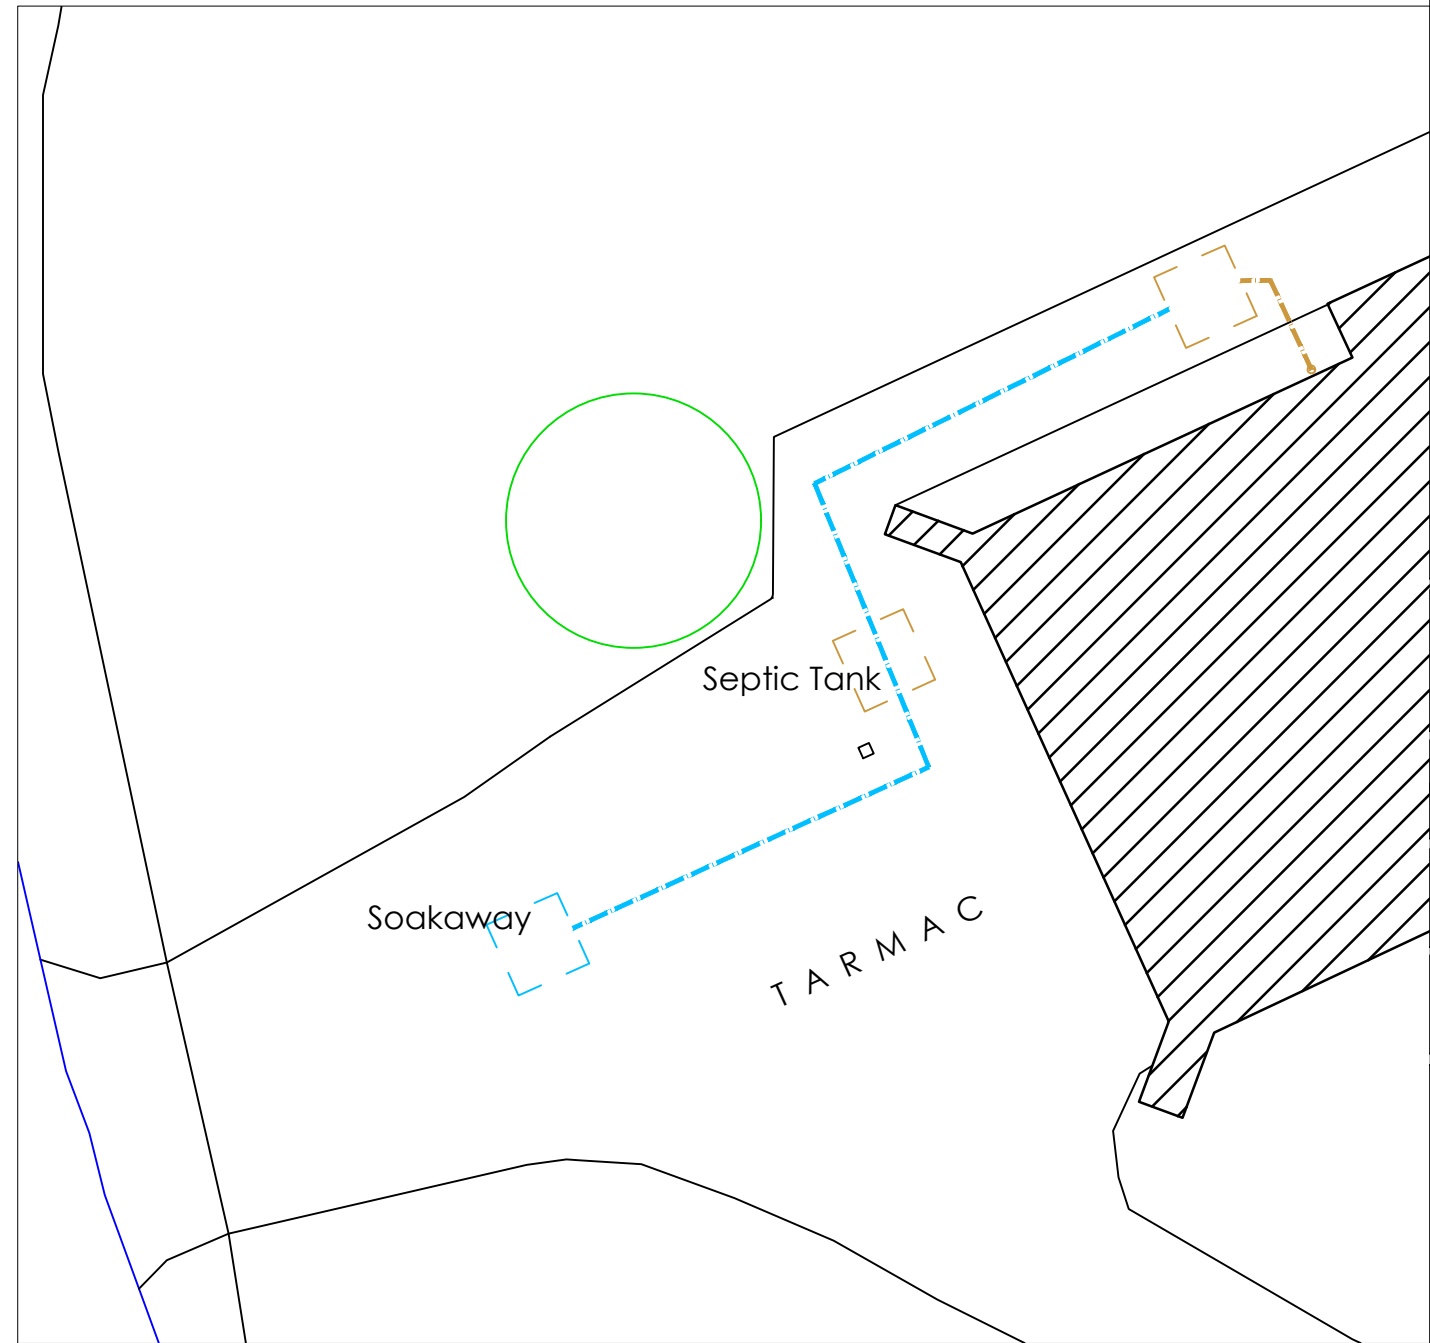

EXT WORKS1:100@A3

Copyright of this drawing is retained by Masefields Marchant Brabbs Limited, not to be reproduced or copied without written consent.

Figured dimensions only to be taken from this drawing. It is the contractors responsibility to check all dimensions.

Any boundaries indicated are those apparent from site survey. They may not be the legal boundaries. These must be verified by the site owner.

Rev A: -/mb/12-03-19 AB

DRAWING STAGE	
F= Feasibility	AB
P= Planning stages	
BR= Building Regulations	
W= Working Drawings	
AB= As built	

CLIENT:
PCC
St Marys Church
Studley

PROJECT:
Hot drinks facility

TITLE:
LOCATION
SITE PLAN

masefields
architects ■ surveyors

Doric House, Church St., Studley Warwickshire B80 7LG
Tel: 01527 910190
Email: architecture@masefields.co.uk

IN ASSOCIATION WITH:

Alan Smith Associates
ASA ■ CHARTERED ARCHITECTS ■
PLANNING and DEVELOPMENT CONSULTANTS

Drawn	Ratio	Checked	
RS	as stated	mb	
Date	Job No	Drg No	Rev
APR 18	3207	11	A