

DRAWING REGISTER & ISSUE SHEET

Project: St Michaels Church East Coker



MANN WILLIAMS
CONSULTING CIVIL AND
STRUCTURAL ENGINEERS
7 OLD KING STREET
BATH BA1 2JW
T 01225 464419
E bath@mannwilliams.co.uk

Project No.		12680	Sheet No.	Issue Date											
Dwg. Nos.	Drawing Title	DWG SIZE	D	16	07	29	30	06							
			M	06	07	09	09	10							
9001 9002 9003 - 0659.WD.004 Proposed Porch Steps-A1_rev - MWB Markup - 0659.WD.009 Proposed Porch and New Access-A1_rev - MWB Markup	Issue Date										Revision				
			P1	P2		P2									
					P1	P1									
						P1	P2								
								-							
									-						
Distribution				No. of Copies											
Company		F.A.O		X = Issue Sheet D = Disk Ep = EMAIL(PDF) Ed = eMail(DWG)											
b2architects		Michael Hancock		Ep	Ep	Ep	Ep	Ep							
C= Construction T=Tender P=Preliminary FD = Final Design Issue															
C= Construction T=Tender P=Preliminary FD = Final Design Issue				Issue Status	P	P	P	P	P						
				Issue By	GAM	GAM	GAM	GAM	GAM						



16th June 2025

michael.hancock@b2architects.com
Micheal Hancock
B2 Architects
The Borough Studio
Wedmore
Somerset
BS28 4EB

Dear Michael

East Coker, St Micheal and All Angels - Structural survey for Proposed Opening

Mann Williams have been instructed by East Coker PCC to provide structural input for a proposed doorway at the Church of St Michaels and All Angels. The church is Grade II* listed (list entry 1345781). We attended site on Monday 9th June 2025 to review the existing structure. Proposed alterations involve the insertion of a disabled access doorway between the transept and the vestry. The survey was a visual survey with limited opening up comprising strips of plaster removal on both faces of the wall to expose the nature of the masonry where the opening is proposed.

The vestry is at the base of the tower, which is in the Northeast corner of the building. The tower is composed of three stages, with the tower measuring approximately 16.5 m high with a 1.16 m high parapet at the top. The current proposal is for an opening in the West wall of this tower, between the transept and current ground floor vestry. The opening will need to be formed with new back to back lintels with capacity to resist the masonry loading from the tower.

In addition to the masonry loading, this wall supports at least one of the upper stages (bell chamber). The direction of loading for the roof and the floor to the ringing chamber could not be ascertained. The floor directly below the Belfry (housing the clock mechanism), was double boarded with floor beams running North-South and this level is not adding to the load of the West tower wall. The original floor beams for the Belfry also ran North-South, but there has been a later insertion of two steel beams, so this stage is now loading the East and West walls of the tower.

Generally, the tower masonry was observed to be in good condition; there was no visual evidence of structural issues within the walls. Some deterioration was noted in the structural timber floors. The inserted steel beams to the floor supporting the bell chamber indicate previous timber bearing decay and one floor beam was noted as having significant beetle activity, this was the westernmost beam supporting the floor to the bell mechanism room. This is not expected to affect the design of the proposed doorway opening, but it is recommended that the condition of existing timbers in the tower are investigated further.

During the survey, two patches of plaster were removed to enable inspection of the wall construction. The Archaeological consultant, Keith Faxon, was present to record the findings. These patches (1.3 m wide x 0.2 m high) revealed random rubble course stone. The individual stones were approximately 140 to 350 mm long and 100 mm high.

Considering the wall composition and the loading requirements, the recommended solution would require local consolidation of stonework and local stitching around the opening using a combination of Cintec anchors and

Mann Williams
Consulting Civil and
Structural Engineers

7 Old King Street
Queen Square
Bath BA1 2JW
T: 01225 464419
www.mannwilliams.co.uk

Also at:
53 Mount Stuart Square
Cardiff CF10 5LR
T: 02920 480333

Directors
Jeff Stott
BA (Hons) CEng MInstE
CARE Accredited Conservation Engineer
Jon Avent
BSc (Hons) CEng MInstE IHBC
CARE Accredited Conservation Engineer
Neil Lancaster
BSc (Hons) CEng MICE
Peter Blankley
BEng (Hons) CEng MICE
Spencer Fereday
BEng (Hons) CEng MInstE

Associates
Stephen Swinbank
BEng (Hons) CEng MICE
Dan Job
MEng (Hons) CEng MInstE
Darren Jones
CEng MICE MInstE
Matt Potter
BSc (Hons)
Ben Chase
MEng (Hons) CEng MICE

Consultants
John Mann
BSc (Hons) CEng FICE
Clive Onions
BSc (Hons) CEng FICE FCIWEM MInstE
Henry Pinder
BA (Hons) MA (Cantab) MEng CEng MInstE

Mann Williams is the trading name of Mann Williams Ltd, Registered in England and Wales
Number 3609498

stainless-steel embedded bars to ensure continued integrity (prior to formation of the opening). Precast reinforced concrete lintels back-to-back would be proposed for the head of the new opening carrying the tower wall over.

The foundation construction and founding geology are not known. British Geological Survey online mapping shows the church is likely sited on Cornbrash Limestone although, there is always potential for foundations to have been formed over softer superficial deposits. A linear feature (fault), inferring displacement in the Cornbrash is noted on BGS mapping immediately north of the tower. To avoid settlement caused by local increased concentration of foundation loading, the structural design would aim to maintain the existing ground bearing stresses; to achieve this without the need for remedial foundation works the 1200 mm wide new structural opening will require a minimum depth of 600 mm of masonry below the base of the opening - given the external levels this seems likely. However, it is recommended that a trial pit is undertaken to ensure a depth of masonry greater than 600mm below the base of the opening is present. To prevent disruption to the internal fabric of the church nave, a modest trial pit could be excavated internally to the vestry where the floor will be renovated as part of the works.

Summary

The masonry at St Michaels and All Angels in East Coker is in good condition and it is structurally feasible to insert a disabled access doorway into the ground floor West wall of the tower. A trial pit is required to confirm that remedial foundation works are not needed. The superstructure design includes back-to-back precast concrete lintels and local reinforcement and consolidation of masonry to the perimeter of the opening with Cintec anchors and stainless-steel reinforcement (refer to our attached drawing).

Please should you have any queries or require any further input at this stage do not hesitate to contact us.

Yours sincerely



Grace Morris

Engineer

Mann Williams

Enc.

Mann Williams
Consulting Civil and
Structural Engineers

7 Old King Street
Queen Square
Bath BA1 2JW
T: 01225 464419
www.mannwilliams.co.uk


Mann Williams is the trading name of Mann Williams Ltd, Registered in England and Wales
Number 3609498

Envisioned sequence of works:

- Conduct a trial pit to establish the depth and condition of existing foundations.
- Remove plaster finishes to each face in the location of the proposed doorway to expose masonry.
- Insert Cintec anchors in the indicated arrangement around the proposed doorway location.
- Rake out pointing and bed in stainless steel reinforcing bars to each face at the indicated locations.
- Insert needle and propping (to Contractors design).
- Locally remove masonry and insert back-to-back reinforced concrete lintels. Ensure minimum 150 mm bearing (consider and account for rubble masonry being removed below the lintel to enable arch forming so that they do not undercut this 150 mm).
- Remove masonry below the new lintels to form doorway.
- Form brick arch and jambs, stitch into the existing and fill between Vousoirs and concrete lintels with reclaimed masonry, stitched into existing.
- Remove needle and propping.
- Repoint and apply finishes to Architect's details.



Do not ring bells during the works. Ensure the mechanical ringing mechanism is disengaged.

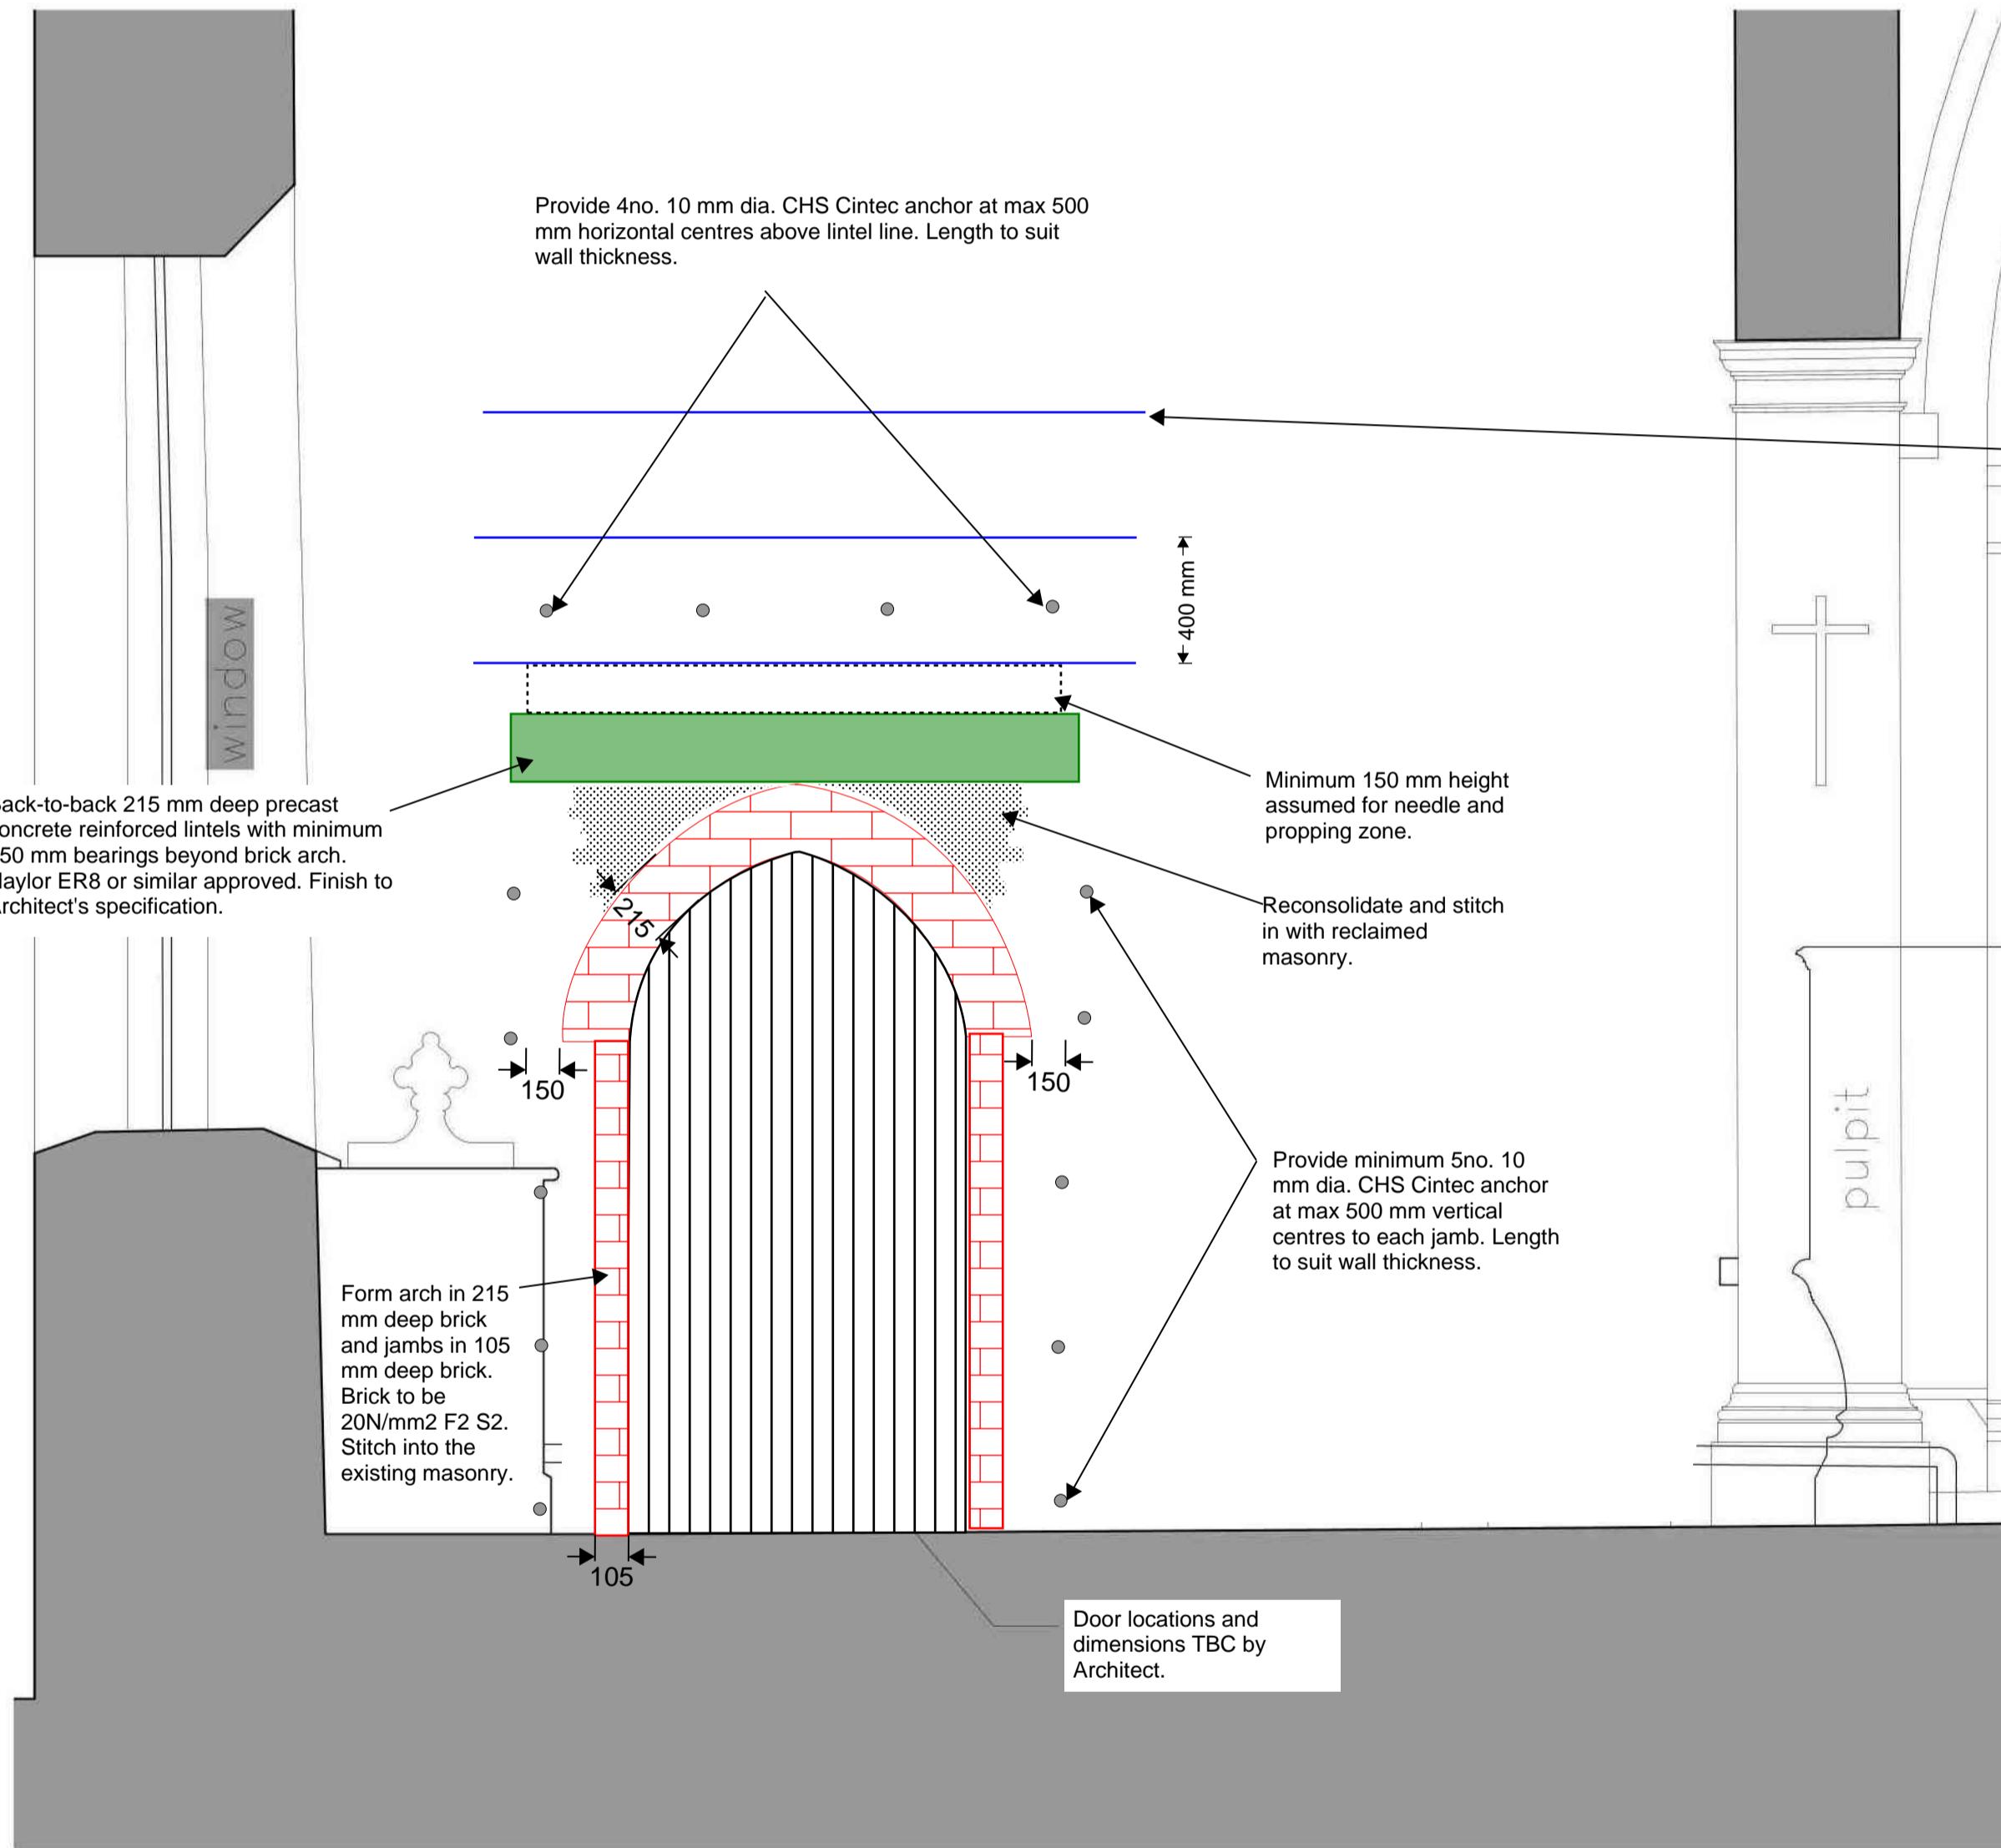

West elevation on proposed opening

1:20



Subject to condition and dimensions of existing foundations. To be determined during works.



Ground floor plan on proposed opening

1:20

STATUS CODES FOR INFORMATION CONTAINERS WITHIN A COMMON DATA ENVIRONMENT IN ACCORDANCE WITH BS EN ISO 19000-2:2018	
CODE	DESCRIPTION
S1	SUITABLE FOR COORDINATION
S2	SUITABLE FOR INFORMATION
S3	SUITABLE FOR REVIEW AND COMMENT
S4	SUITABLE FOR DRAFT REVIEW AND AUTHORIZATION
S5	SUITABLE FOR STAGE REVIEW AND ACCEPTANCE
PUBLISHED (CONTROLLING)	
A1	STAGE 1 AUTHORIZED (NOT FOR CONSTRUCTION)
A2	STAGE 2 AUTHORIZED (NOT FOR CONSTRUCTION)
A3	STAGE 3 AUTHORIZED (NOT FOR CONSTRUCTION)
A4	STAGE 4 AUTHORIZED (FOR CONSTRUCTION)
A5	STAGE 5 AUTHORIZED (FINAL DESIGN RECORD)

NOTES	
1.	THIS DRAWING IS COPYRIGHT AND MAY NOT BE REPRODUCED WITHOUT THE PERMISSION OF MANN WILLIAMS
2.	ALL DRAWINGS ARE TO BE READ IN CONJUNCTION WITH THE PROJECT SPECIFICATION AND WORKS CARRIED OUT IN ACCORDANCE WITH THE LATEST BRITISH STANDARDS AND CODES OF PRACTICE
3.	ANY AMBIGUITIES OR DISCREPANCIES BETWEEN THIS DRAWING AND ANY OTHER INFORMATION GIVEN ELSEWHERE MUST BE REPORTED TO MANN WILLIAMS FOR CLARIFICATION BEFORE WORK PROCEEDS
4.	ALL WORK TO BE BASED ON SITE AND OFFICE DIMENSIONS REPORTED TO THE ENGINEER BEFORE ANY WORK COMMENCES
5.	ONLY FIGURED OR CALCULATED DIMENSIONS SHOULD BE USED AND NO DRAWINGS, IN ANY FORMAT SHOULD BE SCALED

PROJECT CODE	
XX	XX

DRAWING TO BE READ IN COLOUR	
12680	9001

DRAWING TO BE READ IN COLOUR	
P2	

DRAWING TO BE READ IN COLOUR	
DRA	S

DRAWING TO BE READ IN COLOUR	
MWB	

DRAWING TO BE READ IN COLOUR	
12680	9001

DRAWING TO BE READ IN COLOUR	
12680	9001

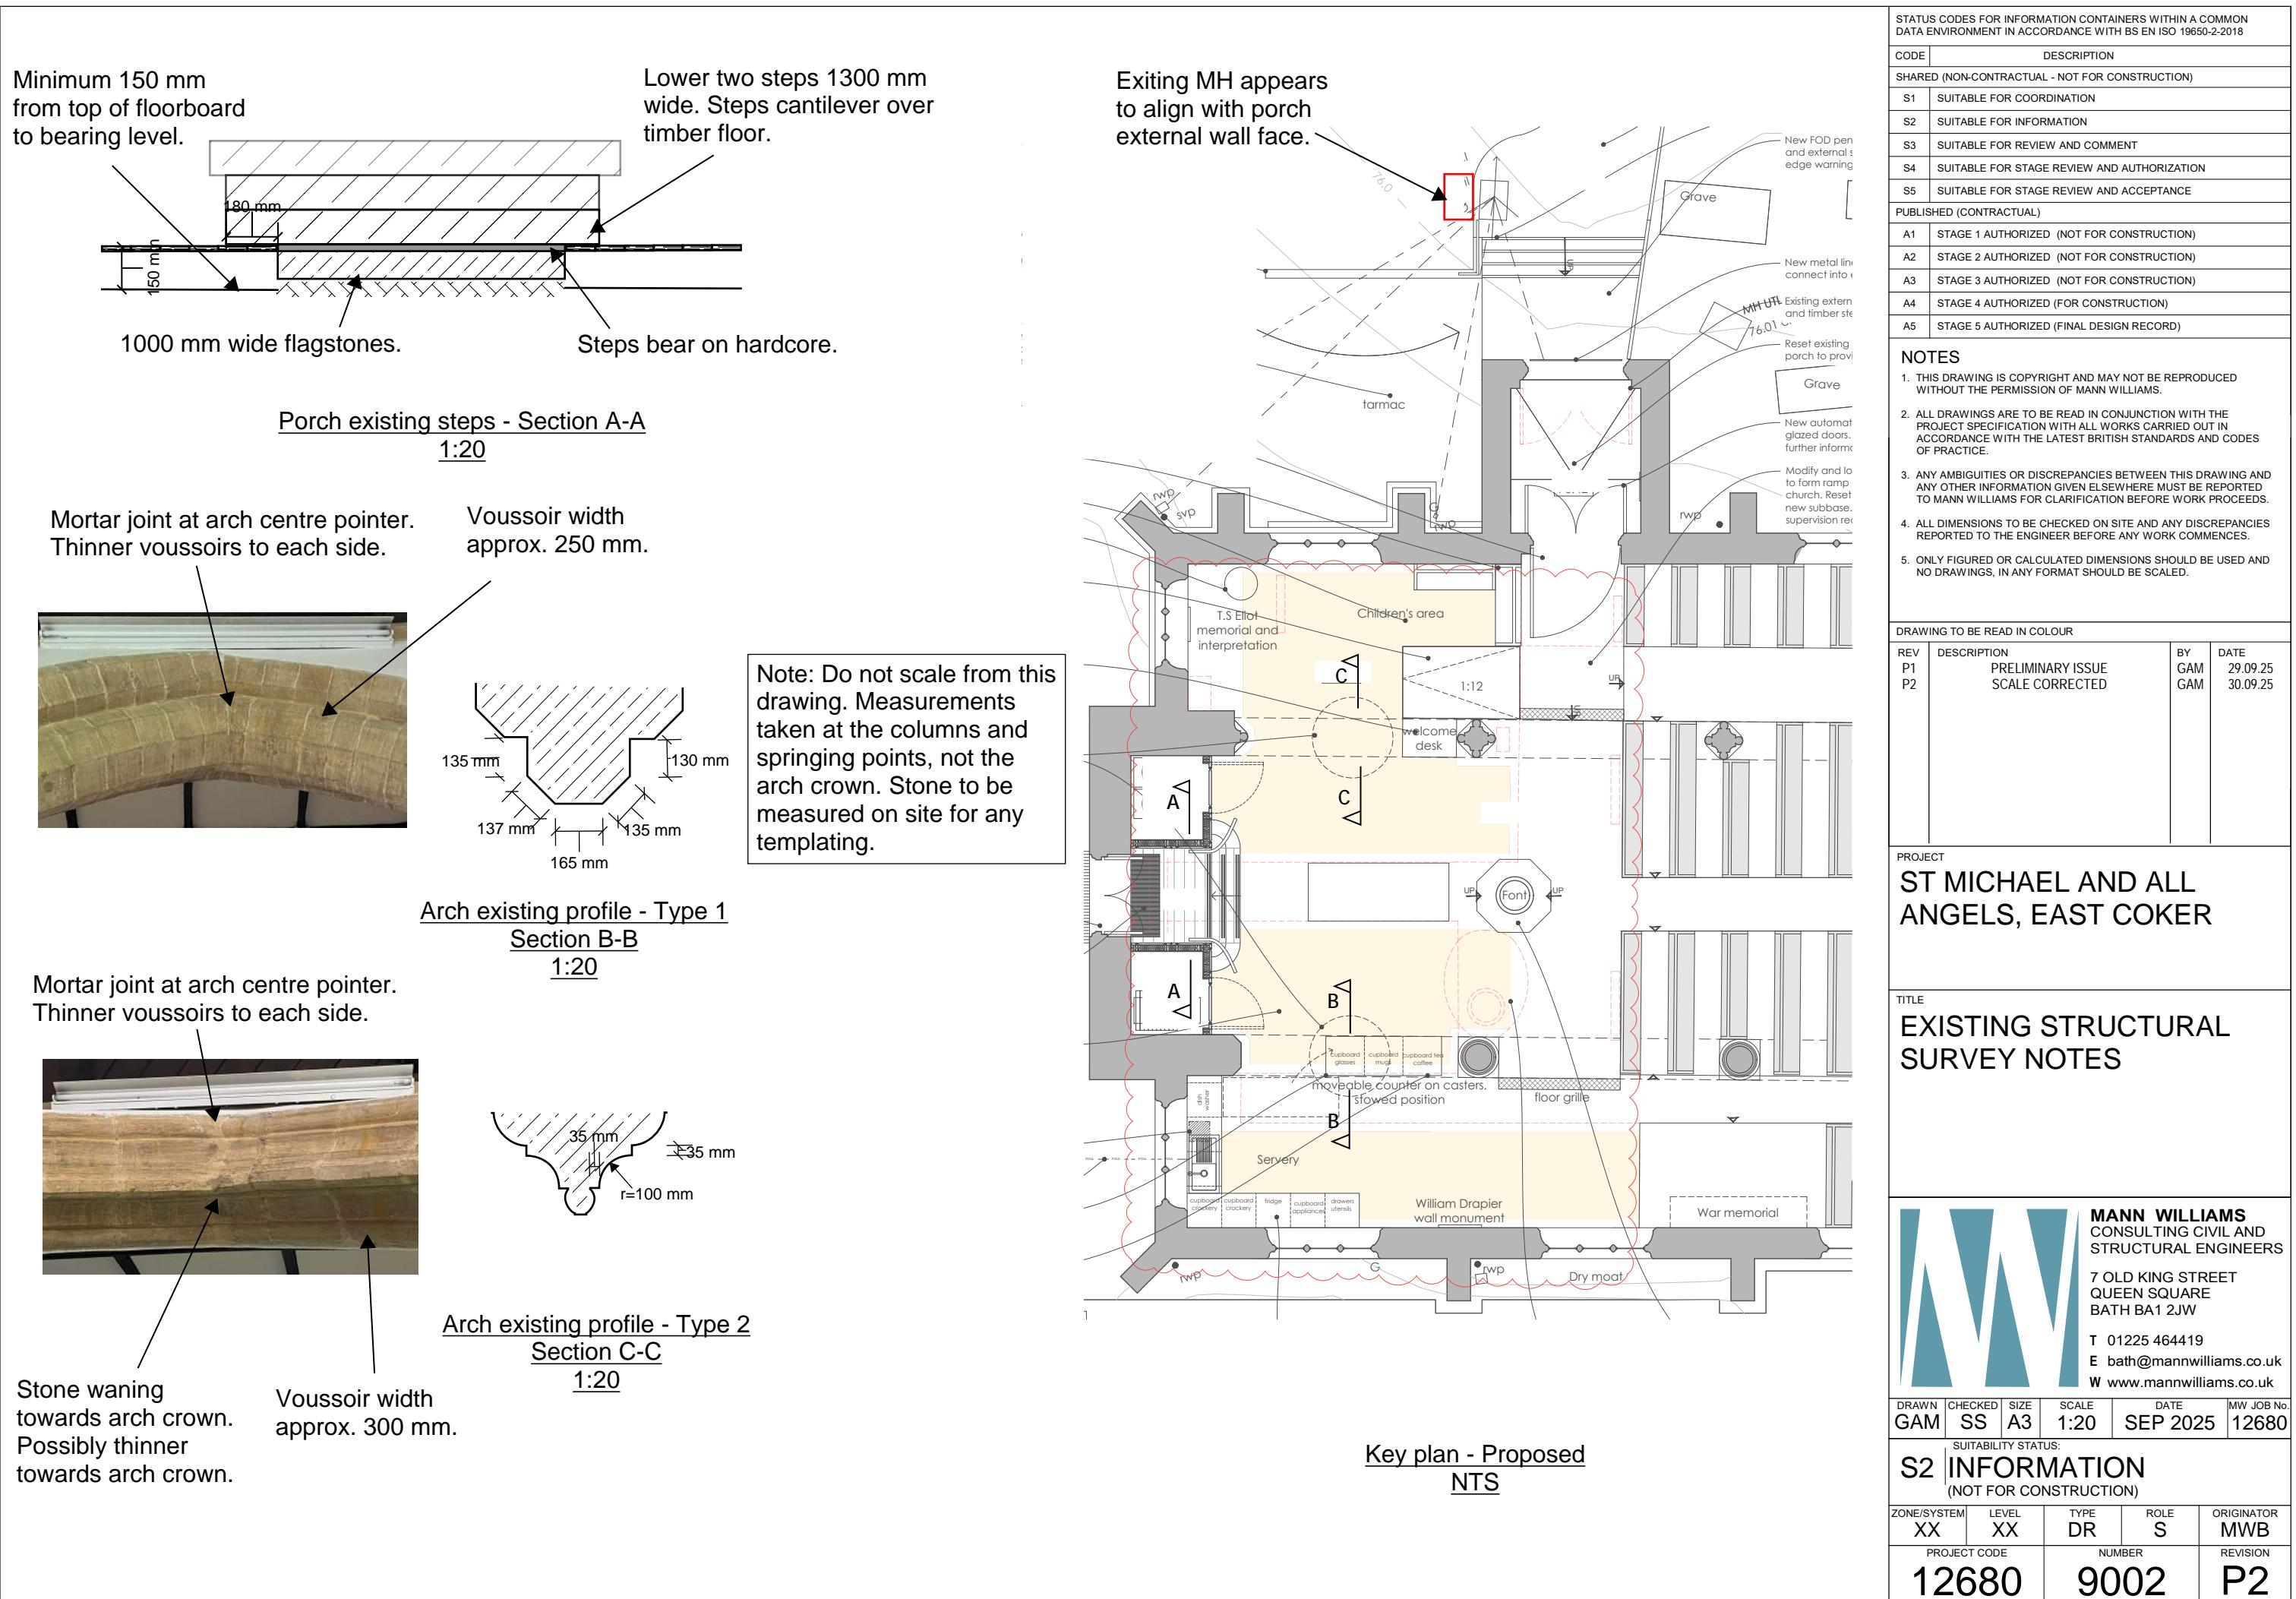


See 12680-MWB-XX-XX-DR-S-9002
for section locations.

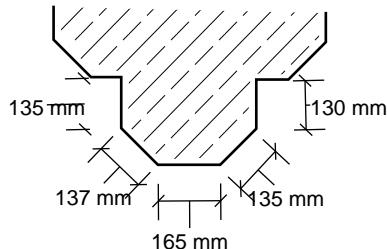

Arch existing profile - Type 1

Section B-B

1:20

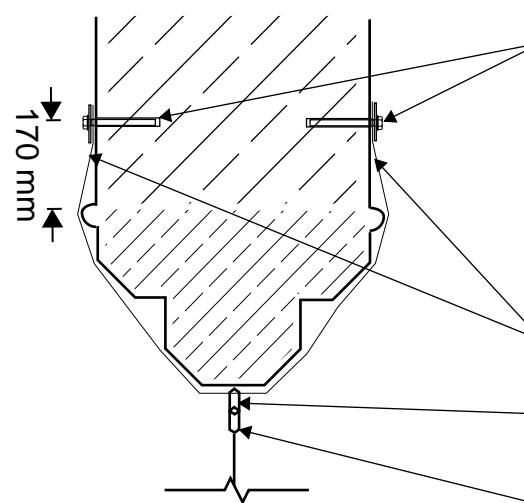


To each face: 1no. M16 Hilti HIS-RN internally threaded sleeve with 170 mm embedment. Resin fix using Hilti HIT-RE 500 V4 to manufacturer's recommendations. Partner with full length M16 stainless steel A4-80 bolt with oversized stainless steel washer. Secure wire system through tightening bolt and washer snug to wall. Washer diameter to exceed factory loop diameter (e.g. 100 mm dia washer for 90 mm dia loop).

Wire factory looped ends to 100 kg safe working load.

Factory installed stainless steel carabiner to suit stainless steel wire diameter. Safe working load 100 kg.

Factory installed Halo heater eyebolt.


Note: Do not scale from this drawing.
Measurements taken at the columns and
springing points, not the arch crown. Stone
to be measured on site for any templating.

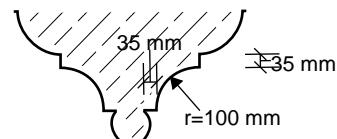

Arch existing profile - Type 2

Section C-C

1:20

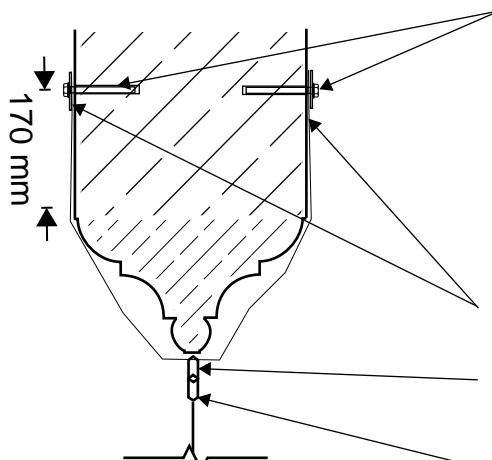

To each face: 1no. M16 Hilti HIS-RN internally threaded sleeve with 170 mm embedment. Resin fix using Hilti HIT-RE 500 V4 to manufacturer's recommendations. Partner with full length M16 stainless steel A4-80 bolt with oversized stainless steel washer. Secure wire system through tightening bolt and washer snug to wall. Washer diameter to exceed factory loop diameter (e.g. 100 mm dia washer for 90 mm dia loop).

Wire factory looped ends to 100 kg safe working load.

Factory installed stainless steel carabiner to suit stainless steel wire diameter. Safe working load 100 kg.

Factory installed Halo heater eyebolt.

STATUS CODES FOR INFORMATION CONTAINERS WITHIN A COMMON DATA ENVIRONMENT IN ACCORDANCE WITH BS EN ISO 19650-2:2018

CODE	DESCRIPTION
SHARED (NON-CONTRACTUAL - NOT FOR CONSTRUCTION)	
S1	SUITABLE FOR COORDINATION
S2	SUITABLE FOR INFORMATION
S3	SUITABLE FOR REVIEW AND COMMENT
S4	SUITABLE FOR STAGE REVIEW AND AUTHORIZATION
S5	SUITABLE FOR STAGE REVIEW AND ACCEPTANCE
PUBLISHED (CONTRACTUAL)	
A1	STAGE 1 AUTHORIZED (NOT FOR CONSTRUCTION)
A2	STAGE 2 AUTHORIZED (NOT FOR CONSTRUCTION)
A3	STAGE 3 AUTHORIZED (NOT FOR CONSTRUCTION)
A4	STAGE 4 AUTHORIZED (FOR CONSTRUCTION)
A5	STAGE 5 AUTHORIZED (FINAL DESIGN RECORD)

NOTES

1. THIS DRAWING IS COPYRIGHT AND MAY NOT BE REPRODUCED WITHOUT THE PERMISSION OF MANN WILLIAMS.
2. ALL DRAWINGS ARE TO BE READ IN CONJUNCTION WITH THE PROJECT SPECIFICATION WITH ALL WORKS CARRIED OUT IN ACCORDANCE WITH THE LATEST BRITISH STANDARDS AND CODES OF PRACTICE.
3. ANY AMBIGUITIES OR DISCREPANCIES BETWEEN THIS DRAWING AND ANY OTHER INFORMATION GIVEN ELSEWHERE MUST BE REPORTED TO MANN WILLIAMS FOR CLARIFICATION BEFORE WORK PROCEEDS.
4. ALL DIMENSIONS TO BE CHECKED ON SITE AND ANY DISCREPANCIES REPORTED TO THE ENGINEER BEFORE ANY WORK COMMENCES.
5. ONLY FIGURED OR CALCULATED DIMENSIONS SHOULD BE USED AND NO DRAWINGS, IN ANY FORMAT SHOULD BE SCALED.

DRAWING TO BE READ IN COLOUR

REV	DESCRIPTION	BY	DATE
P1	PRELIMINARY ISSUE	BY GAM	30.09.25
P2	FITTING LOCATION AND ARRANGEMENT CHANGED	GAM	06.10.25

PROJECT

ST MICHAEL AND ALL ANGELS, EAST COKER

TITLE

PROPOSED HEATER FITTINGS



DRAWN CHECKED SIZE SCALE DATE MW JOB No.
GAM SS A3 1:20 SEP 2025 12680


SUITABILITY STATUS:
S2 INFORMATION
(NOT FOR CONSTRUCTION)

ZONE/SYSTEM LEVEL TYPE ROLE ORIGINATOR
XX XX DR S MWB

PROJECT CODE NUMBER REVISION
12680 9003 P2



In abeyance. Allow for fixing to concrete.
Weld with 6 mm fillet weld full length to 150 mm x 150 mm x 10 mm S355 baseplate. Secure to concrete using 4 no. M12 bolts cast into concrete at 100 mm spacings (25 mm edge distance). Max eccentricity 50 mm.

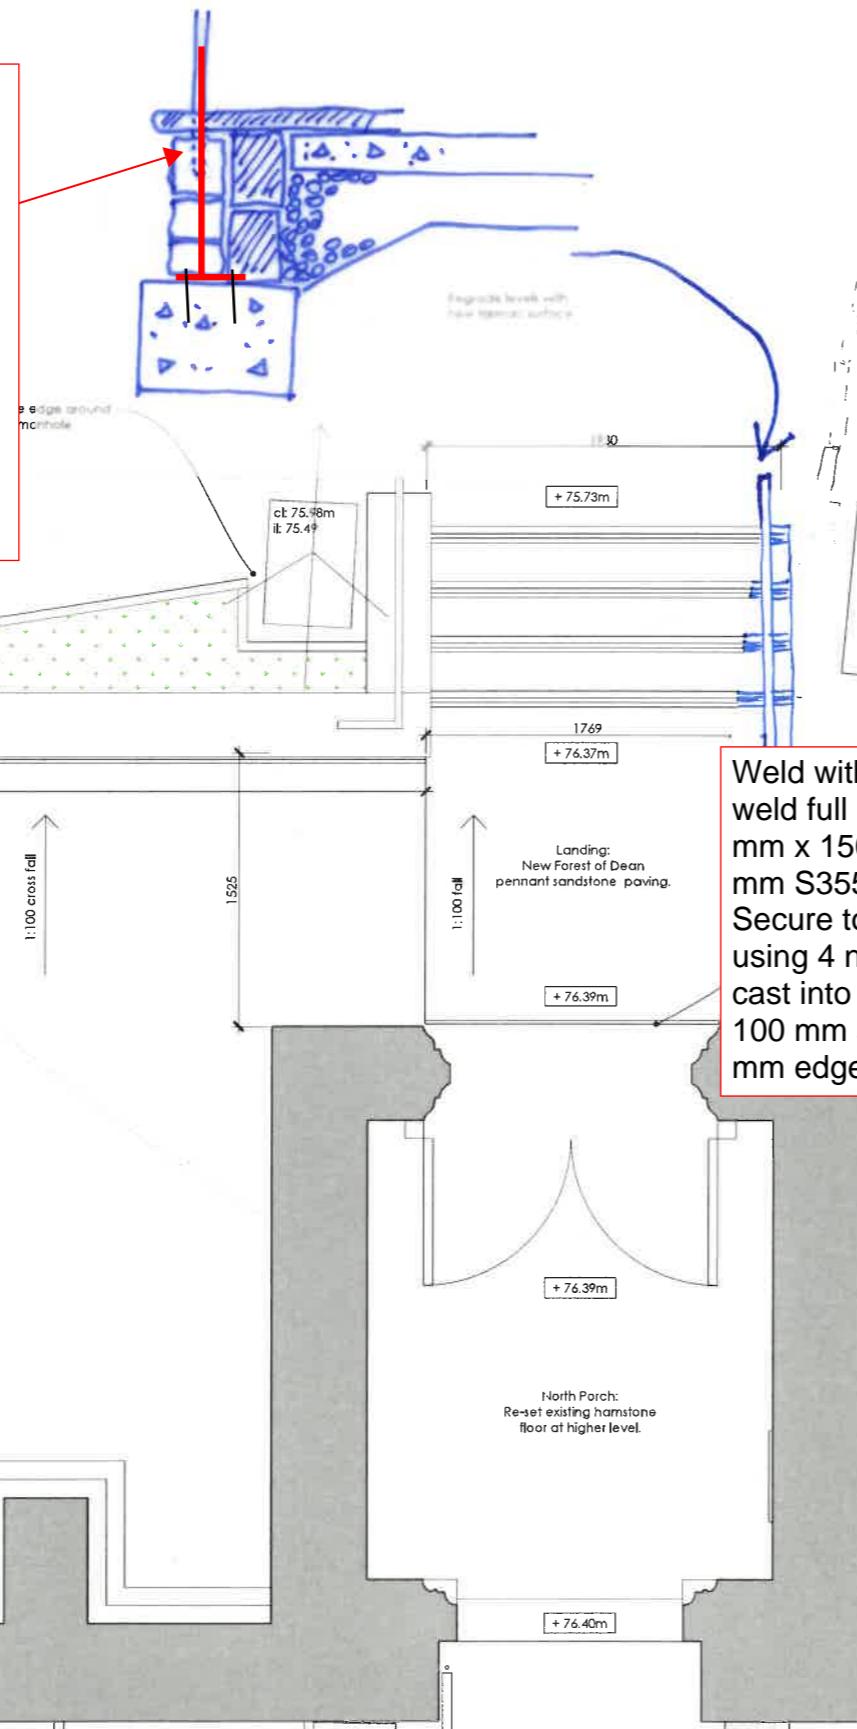


Mild steel convex bar with square edges handrail 38x12mm with scroll ends. Welded Mild steel 12x12mm spindles at regular centres. All galvanised and painted black. Set spindles 175mm into stone and fix with hot lead method.

Posts minimum 20 x 20 in S355 steel at current spacing (640 mm). Architect to confirm.

© The Drawing is the copyright of Beaufort + Beauchamp Architects Ltd.
All dimensions to be checked on site by contractor and not scaled from the drawing.
Any variation + bedlam and rework shall incur no liability for any expense, loss or damage, whether or not arising from any variation made to the drawing, or in the execution of the work to which it relates, which has not been referred to them and their approval obtained.

Weld with 6 mm fillet weld full length to 150 mm x 150 mm x 10 mm S355 baseplate. Secure to concrete using 4 no. M12 bolts cast into concrete at 100 mm spacings (25 mm edge distance).

SECTION THROUGH STEPS 1:10

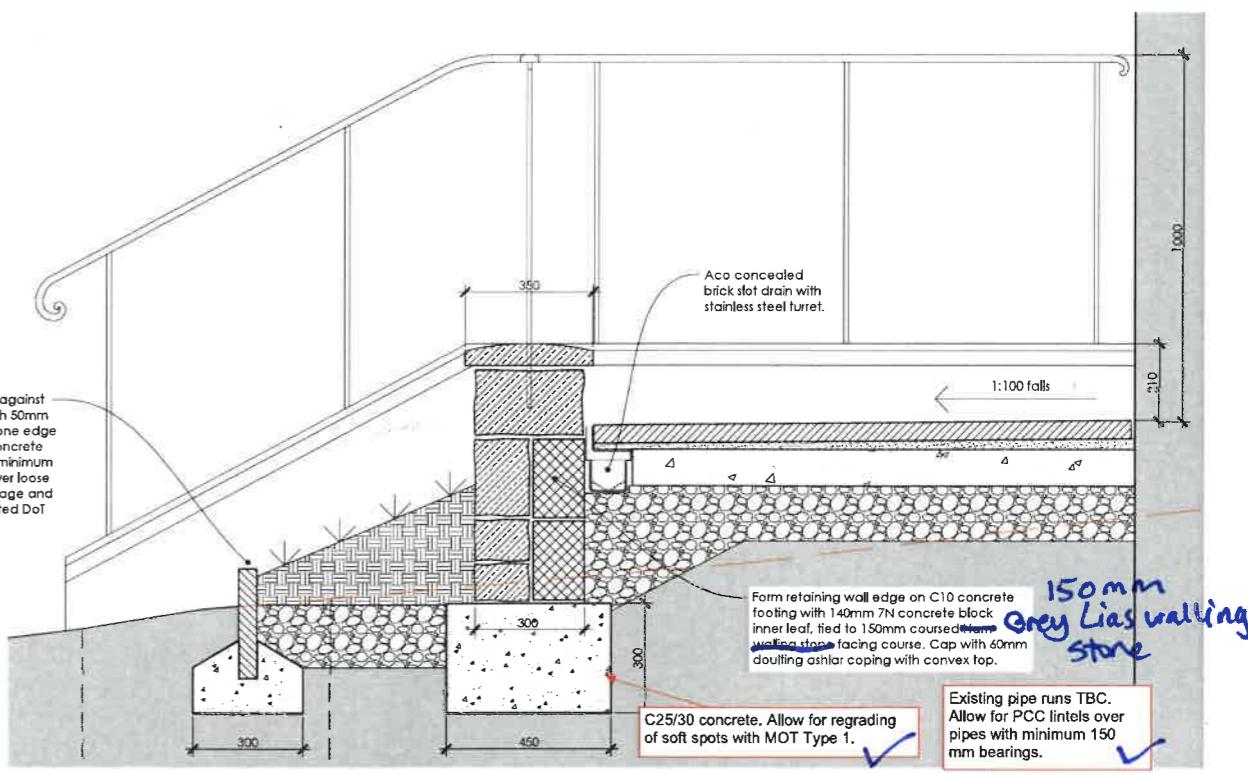

SECTION THROUGH RETAINING EDGE 1:10

Mann Williams
Structural Comments
30/09/2025

EAST COKER St Michael and All Angels
Proposed Porch and New Access

WORKING DRAWING

mh 24.09.25 varies at A1

0659.WD.009 -

